EXHIBIT A Doc.# 1930951

PLAT OF SURVEY

by

REBIK & Associates, Inc.
Land and Construction Surveys
825 Village Quarter Rd., Suite B-1
Dundee, Ill. 60118 (312) 428-3456

of

SCANNED FROM COPY
PROVIDED BY CUSTOMER AT
TIME OF RECORDING

NORTH

1930951 7-1478

U.S. ROUTE 14 (NORTHWEST HIGHWAY)

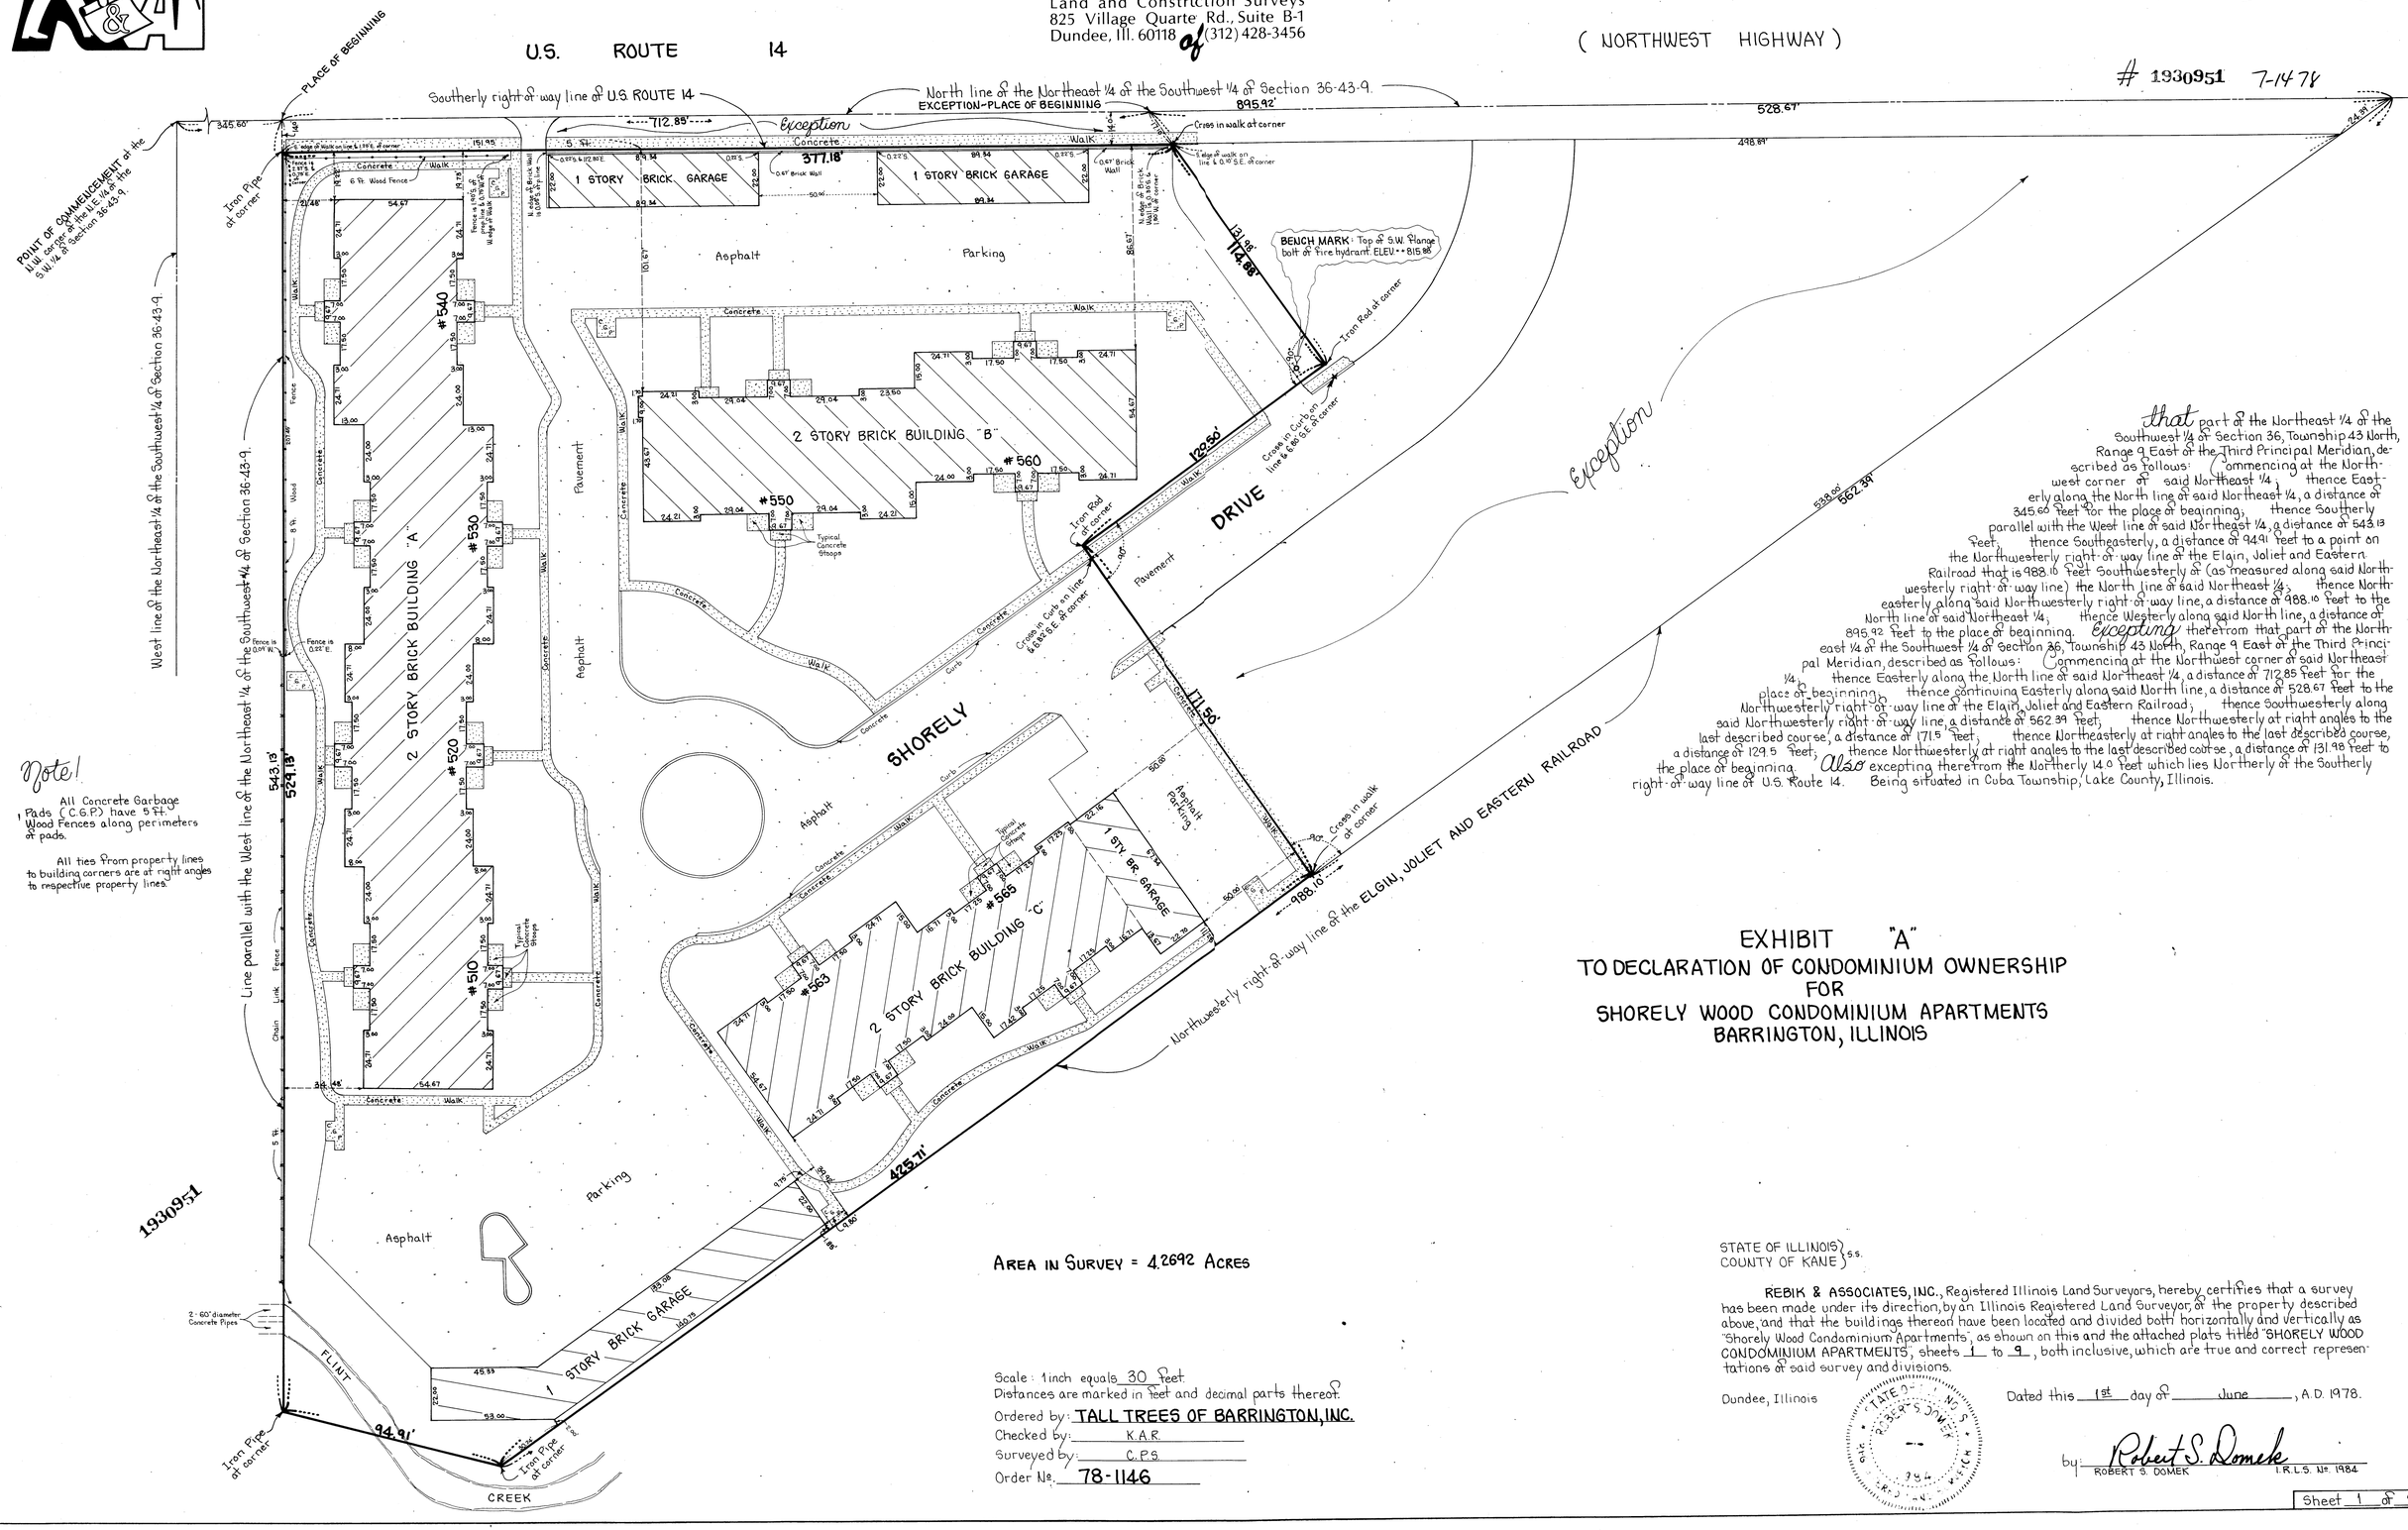

Note!

All Concrete Garbage Pads (C.G.P.) have 5 Ft. Wood Fences along perimeters of pads.

All ties from property lines to building corners are at right angles to respective property lines.

1930951

that part of the Northeast 1/4 of the Southwest 1/4 of Section 36, Township 43 North, Range 9 East of the Third Principal Meridian, described as follows: Commencing at the Northwest corner of said Northeast 1/4; thence Easterly along the North line of said Northeast 1/4, a distance of 345.60 feet for the place of beginning; thence Southerly parallel with the West line of said Northeast 1/4, a distance of 543.13 feet, thence Southeasterly, a distance of 94.91 feet to a point on the Northwesterly right-of-way line of the Elgin, Joliet and Eastern Railroad that is 988.10 feet Southwesterly of (as measured along said Northwesterly right-of-way line) the North line of said Northeast 1/4; thence Northeasterly along said Northwesterly right-of-way line, a distance of 988.10 feet to the North line of said Northeast 1/4; thence Westerly along said North line, a distance of 895.92 feet to the place of beginning. excepting therefrom that part of the North east 1/4 of the Southwest 1/4 of Section 36, Township 43 North, Range 9 East of the Third Principal Meridian, described as follows: Commencing at the Northwest corner of said Northeast 1/4; thence Easterly along the North line of said Northeast 1/4, a distance of 712.85 feet for the place of beginning; thence continuing Easterly along said North line, a distance of 528.67 feet to the Northwesterly right-of-way line of the Elgin, Joliet and Eastern Railroad; thence Southwesterly along said Northwesterly right-of-way line, a distance of 562.39 feet, thence Northwesterly at right angles to the last described course, a distance of 171.5 feet; thence Northeasterly at right angles to the last described course, a distance of 129.5 feet; thence Northwesterly at right angles to the last described course, a distance of 131.98 feet to the place of beginning. Also excepting therefrom the Northerly 14.0 feet which lies Northerly of the Southerly right-of-way line of U.S. Route 14. Being situated in Cuba Township, Lake County, Illinois.

EXHIBIT "A"
TO DECLARATION OF CONDOMINIUM OWNERSHIP
FOR
SHORELY WOOD CONDOMINIUM APARTMENTS
BARRINGTON, ILLINOIS

AREA IN SURVEY = 4.2692 ACRES

Scale: 1 inch equals 30 feet.
Distances are marked in feet and decimal parts thereof.
Ordered by: TALL TREES OF BARRINGTON, INC.
Checked by: K.A.R.
Surveyed by: C.P.S.
Order No.: 78-1146

STATE OF ILLINOIS }
COUNTY OF KANE } S.S.

REBIK & ASSOCIATES, INC., Registered Illinois Land Surveyors, hereby certifies that a survey has been made under its direction, by an Illinois Registered Land Surveyor, of the property described above, and that the buildings thereon have been located and divided both horizontally and vertically as "Shorely Wood Condominium Apartments", as shown on this and the attached plats titled "SHORELY WOOD CONDOMINIUM APARTMENTS", sheets 1 to 9, both inclusive, which are true and correct representations of said survey and divisions.

Dundee, Illinois

Dated this 1st day of June, A.D. 1978.

STATE OF ILLINOIS — ROBERT S. DOMEK — 1984 — I.R.L.S.

by: Robert S. Domek
ROBERT S. DOMEK I.R.L.S. No. 1984

1930951
7-14-78

SCANNED FROM COPY
PROVIDED BY CUSTOMER AT
TIME OF RECORDING

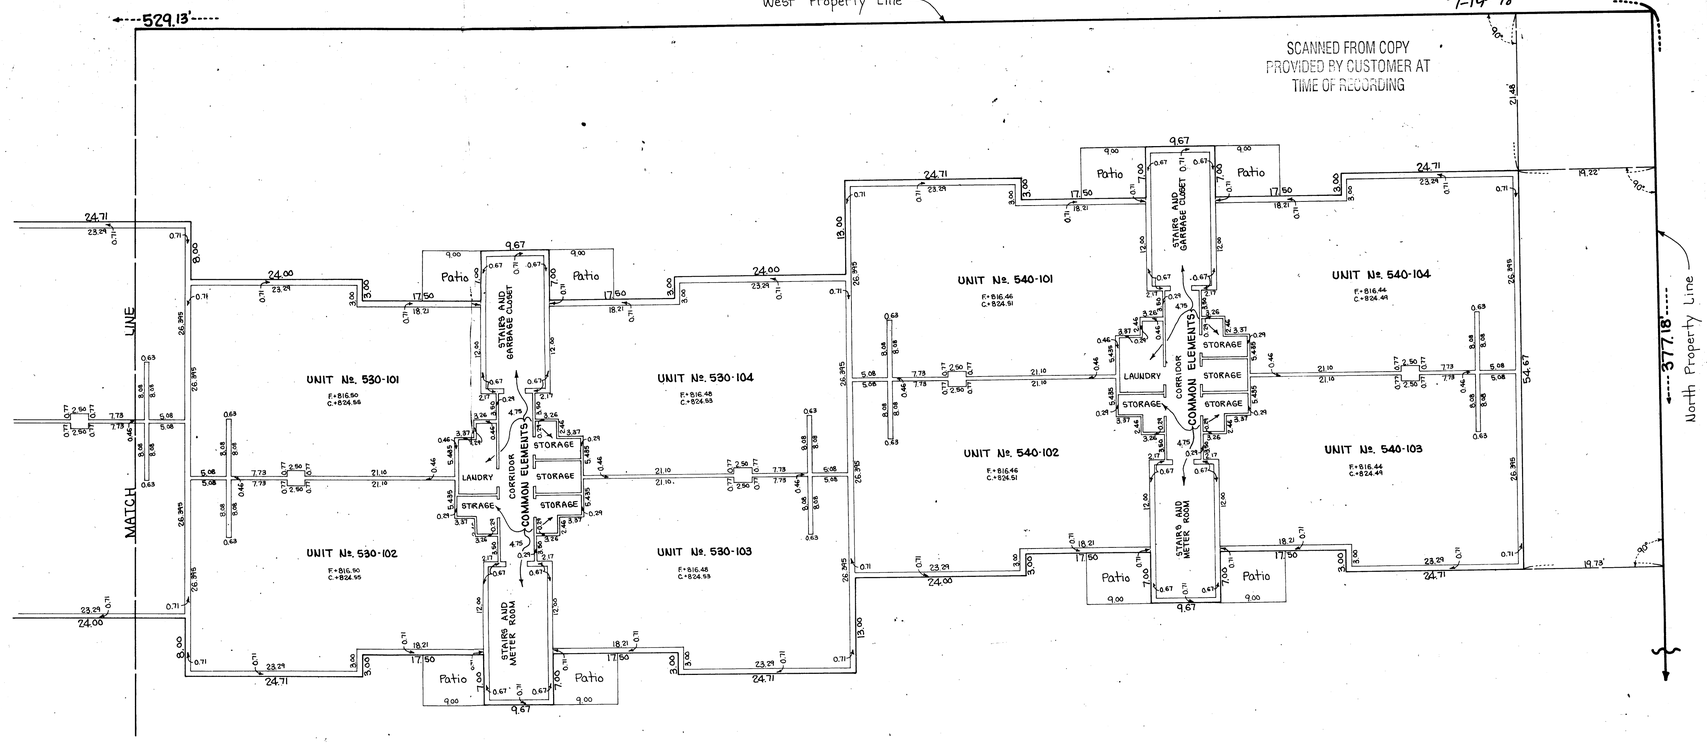

1930951

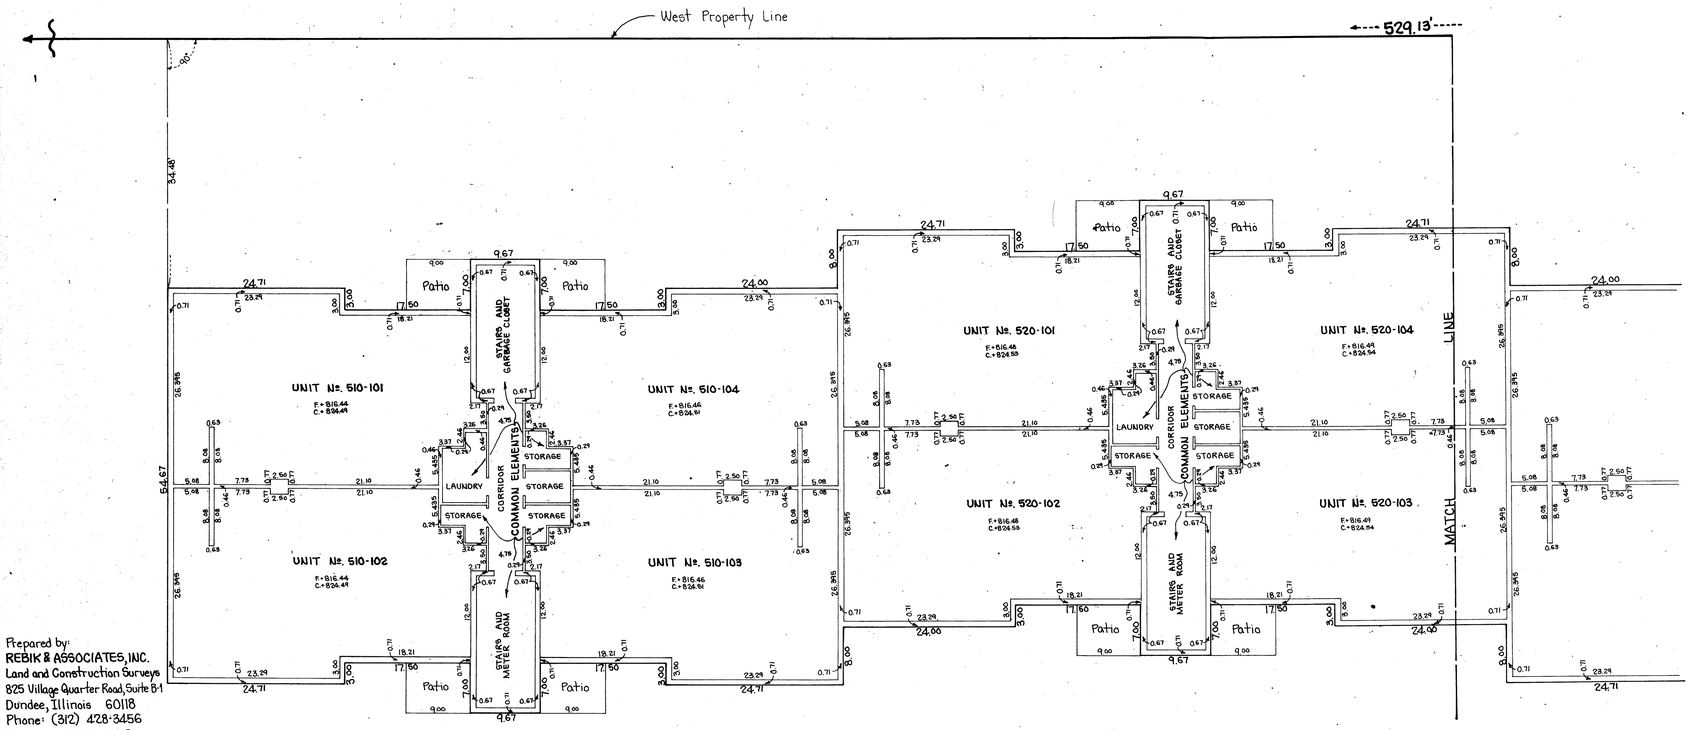

1930951

NORTH

Note!

Horizontal boundaries of units are formed by the interior surface of the concrete floors and the interior finished surface of the ceilings.

Vertical boundaries of units are formed by the interior finished surface of the perimeter walls and the lateral extensions thereof.

Note!

All elevations shown hereon (C.= Ceiling elevation ~ F.= Floor elevation) refer to: BENCH MARK: Top of Southwest flange bolt of Fire Hydrant located 9 feet South and 71 feet East of the Northeast corner of Building "B"; ELEVATION = +815.88.

All dimensions and elevations are shown in feet and decimal parts thereof.

Prepared by:
REBIK & ASSOCIATES, INC.
Land and Construction Surveys
825 Village Quarter Road, Suite B-1
Dundee, Illinois 60118
Phone: (312) 428-3456

ORDER NO. 78-1146

1ST FLOOR
BUILDING "A"
SHORELY WOOD CONDOMINIUM APARTMENTS
BARRINGTON, ILLINOIS

1930951

Scale: 1 inch = 10 feet Date: June 1st, 1978

#1930951 7-14-78

SCANNED FROM COPY
PROVIDED BY CUSTOMER AT
TIME OF RECORDING

1930951

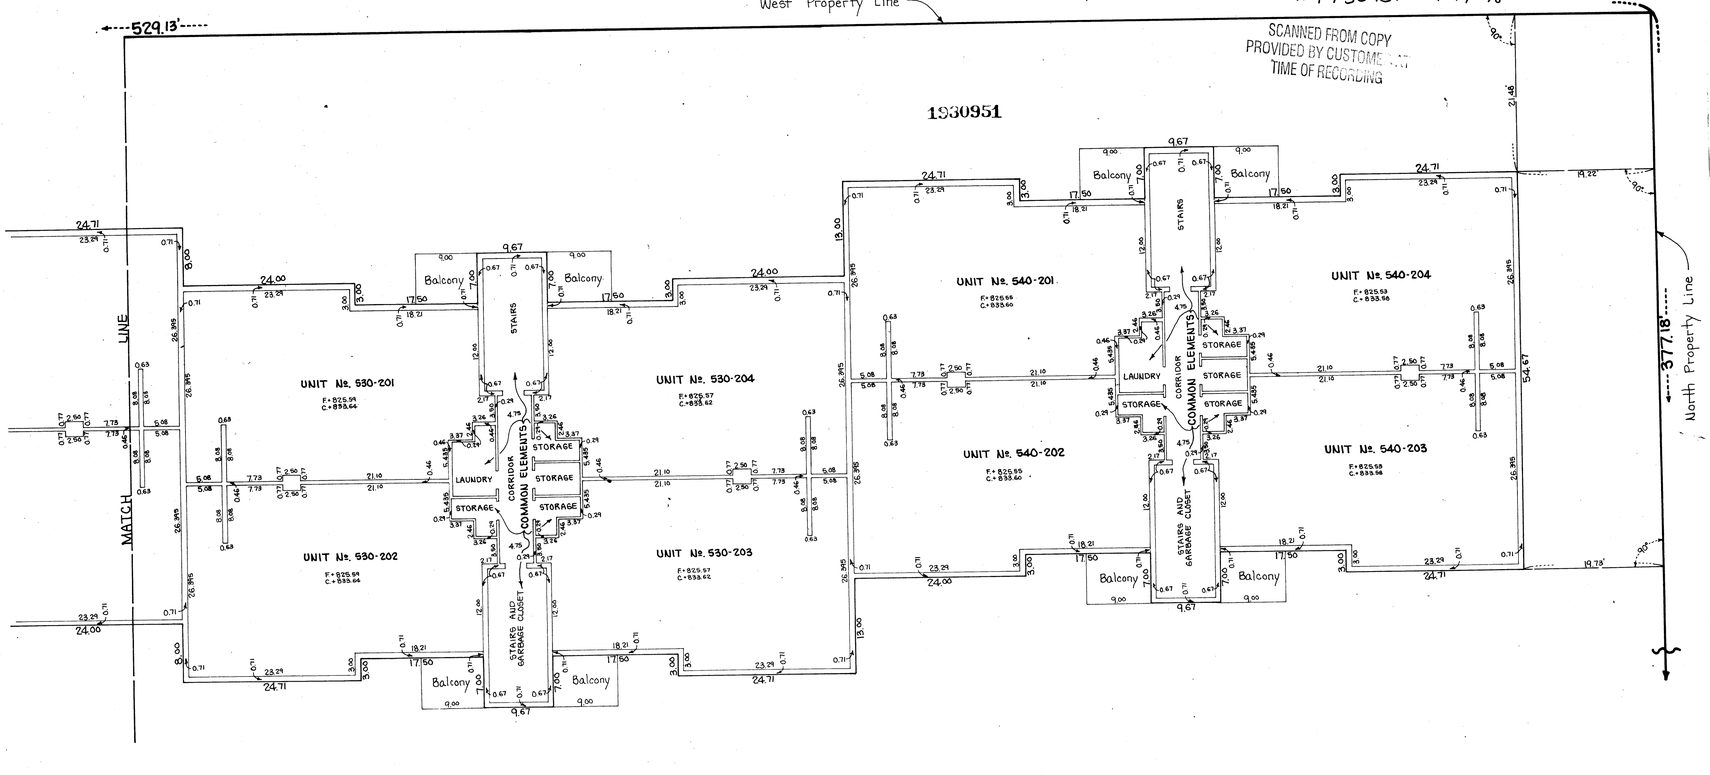

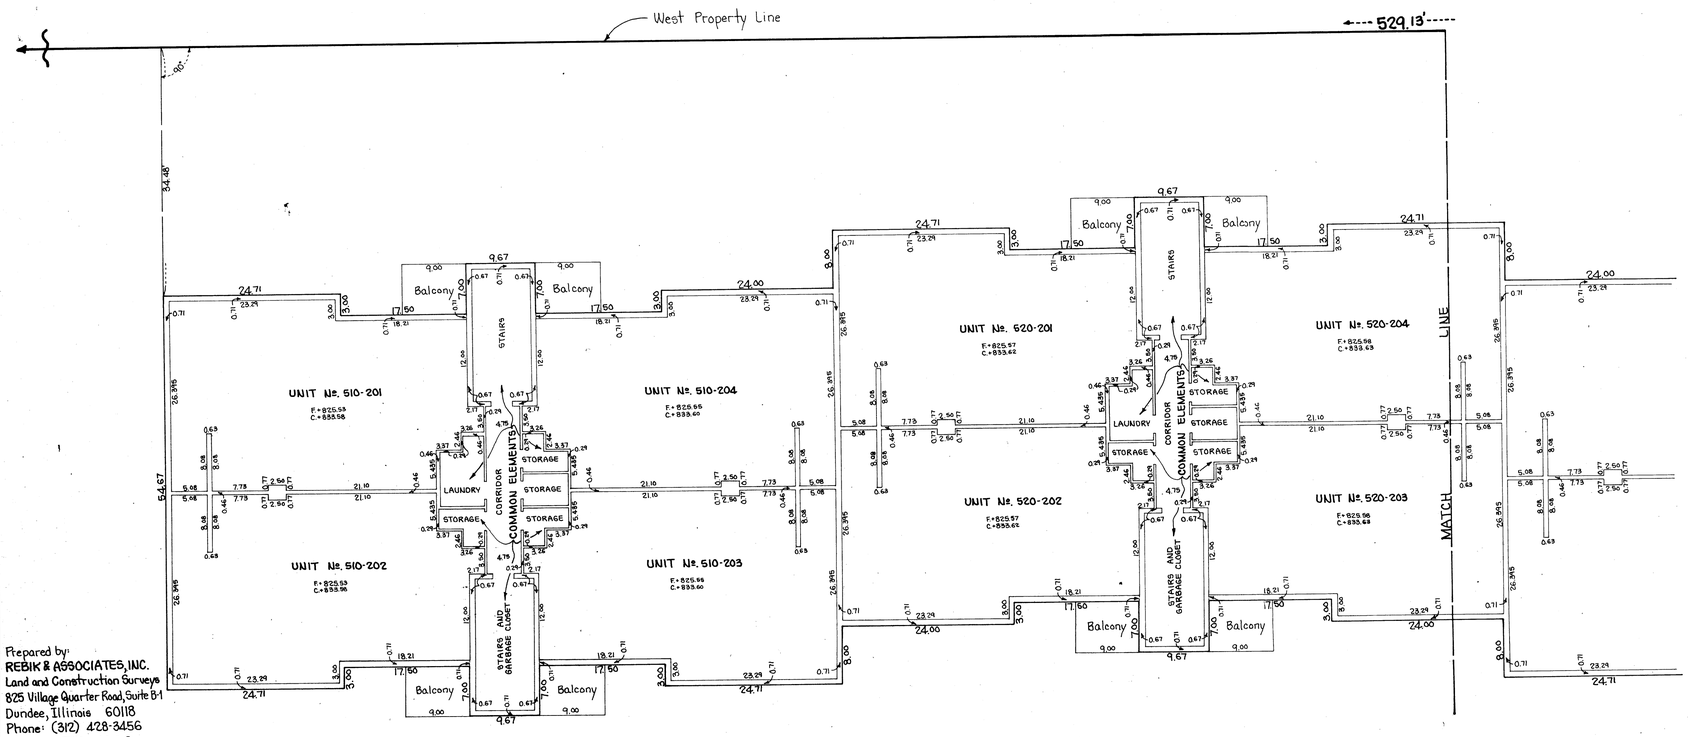

Note!

Horizontal boundaries of units are formed by the interior surface of the concrete floors and the interior finished surface of the ceilings.

Vertical boundaries of units are formed by the interior finished surface of the perimeter walls and the lateral extensions thereof.

Note!

- All elevations shown hereon (C = Ceiling elevation - F = Floor elevation) refer to: BENCH MARK: Top of Southwest Flange bolt of Fire Hydrant located 9 feet South and 71 feet East of the Northeast corner of Building "B"; ELEVATION = + 815.88.

All dimensions and elevations are shown in feet and decimal parts thereof.

Prepared by:
REBIK & ASSOCIATES, INC.
Land and Construction Surveys
825 Village Quarter Road, Suite B-1
Dundee, Illinois 60118
Phone: (312) 428-3456

ORDER No. 78-1146

2ND FLOOR
BUILDING "A"
SHORELY WOOD CONDOMINIUM APARTMENTS
BARRINGTON, ILLINOIS

1930951 Scale: 1 inch = 10 Feet Date: June 1st, 1978

#1930951
7-14-78

SCANNED FROM COPY
PROVIDED BY CUSTODIAN AT
TIME OF RECORDING

NORTH

North Property Line
377.18'

West Property Line
529.13'

1930951

HOSPITALITY SUITE
COMMON ELEMENTS

UNIT No. 550-102
F=816.54
C=824.54

UNIT No. 550-103
F=816.53
C=824.58

UNIT No. 550-104
F=816.53
C=824.58

UNIT No. 560-101
F=816.53
C=824.58

UNIT No. 560-102
F=816.93
C=824.58

UNIT No. 560-103
F=816.92
C=824.57

UNIT No. 560-104
F=816.92
C=824.97

STAIRS AND GARBAGE CLOSET

STAIRS AND METER ROOM

CORRIDOR COMMON ELEMENTS

LAUNDRY

STORAGE

Patio

Note!

All elevations shown hereon (C.= Ceiling elevation ~ F.= Floor elevation) refer to: **BENCH MARK**: Top of Southwest flange bolt of Fire Hydrant located 9 Feet South and 71 Feet East of the Northeast corner of Building "B", ELEVATION = +815.88.

All dimensions and elevations are shown in feet and decimal parts thereof.

Note!

Horizontal boundaries of units are formed by the interior surface of the concrete floors and the interior finished surface of the ceilings.

Vertical boundaries of units are formed by the interior finished surface of the perimeter walls and the lateral extensions thereof.

1930951

1930951

Prepared by:
REBIK & ASSOCIATES, INC.
Land and Construction Surveys
825 Village Quarter Road, Suite B-1
Dundee, Illinois 60118
Phone: (312) 428-3456

ORDER No. 78-1146

1ST FLOOR
BUILDING "B"
SHORELY WOOD CONDOMINIUM APARTMENTS
BARRINGTON, ILLINOIS

Scale: 1 inch = 10 feet Date: June 1st, 1978

SCANNED FROM PROVIDED BY TIME OF ... AT
#1930951
7-14-78

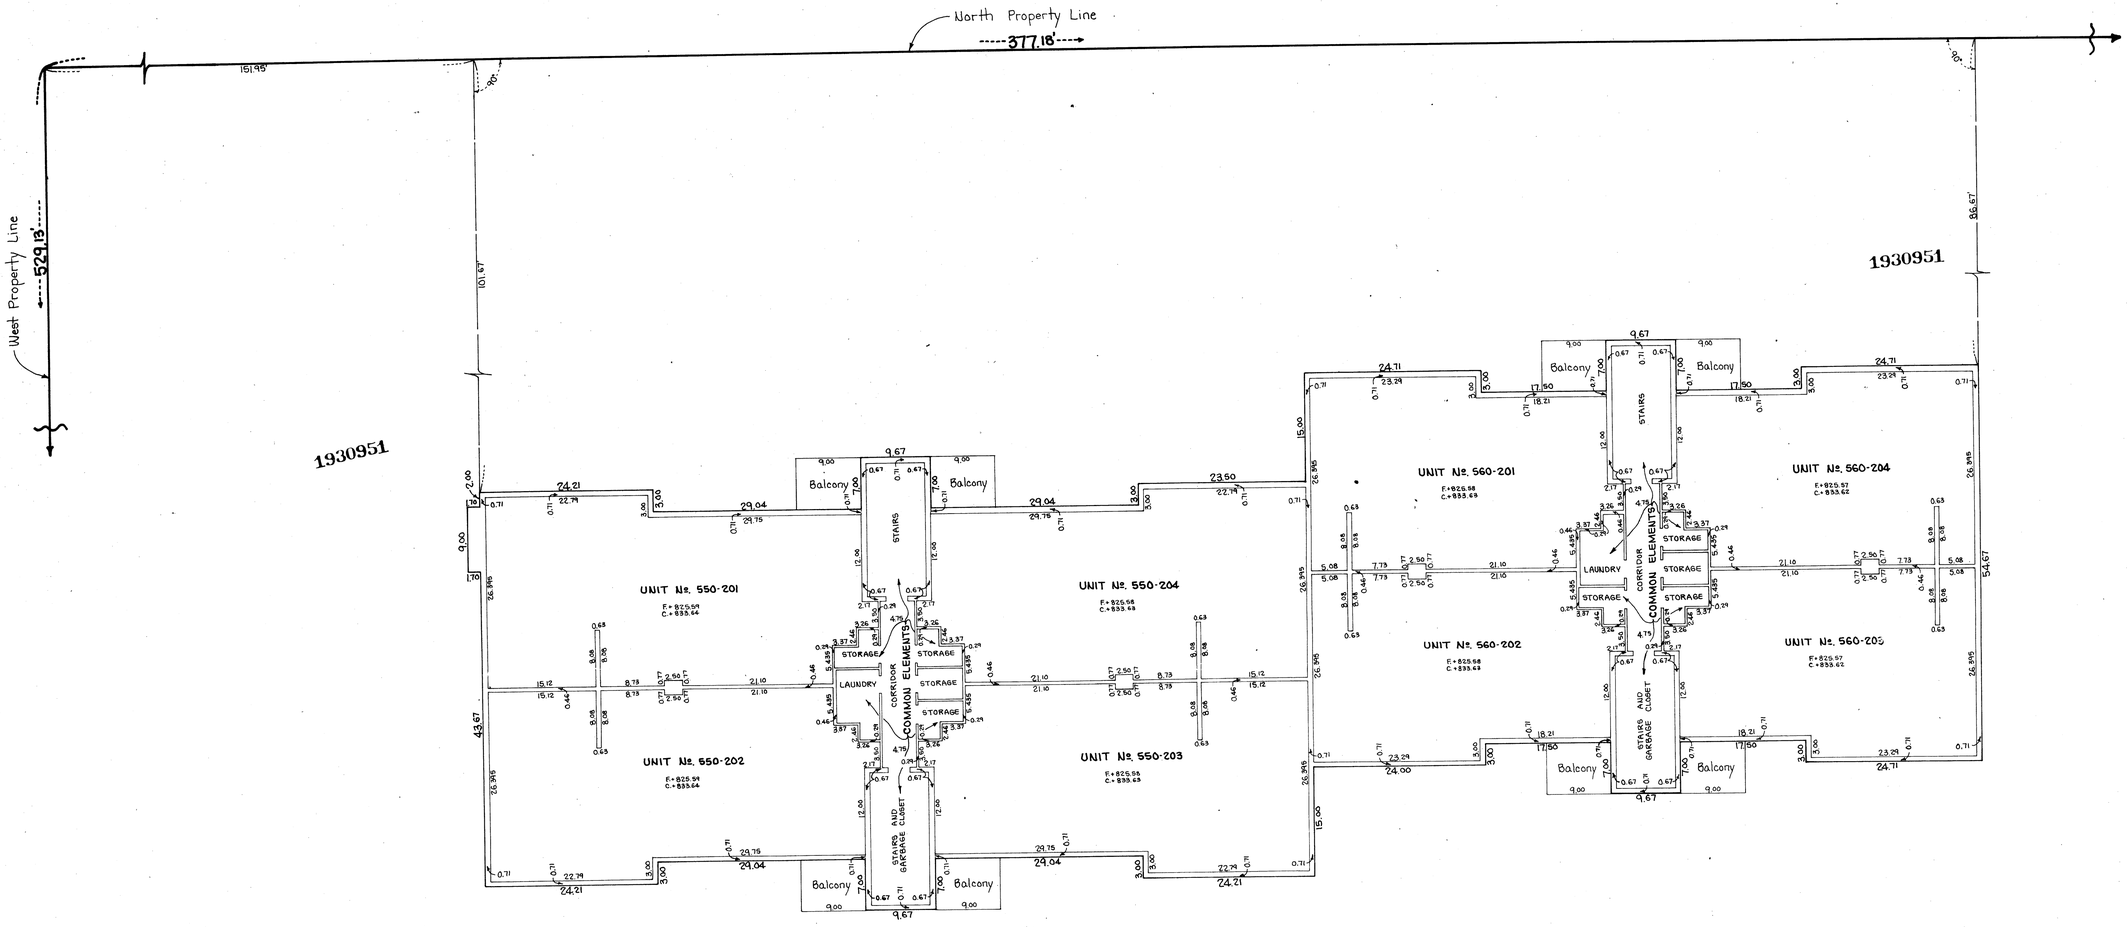

Note!

All elevations shown hereon (C.= Ceiling elevation - F.= Floor elevation) refer to: **BENCH MARK**: Top of Southwest flange bolt of Fire Hydrant located 9 feet South and 71 feet East of the Northeast corner of Building "B"; ELEVATION = + 815.88.

All dimensions and elevations are shown in feet and decimal parts thereof.

Note!

Horizontal boundaries of units are formed by the interior surface of the concrete floors and the interior finished surface of the ceilings.

Vertical boundaries of units are formed by the interior finished surface of the perimeter walls and the lateral extensions thereof.

Prepared by:
REBIK & ASSOCIATES, INC.
Land and Construction Surveys
825 Village Quarter Road, Suite B-1
Dundee, Illinois 60118
Phone: (312) 428-3456

ORDER No. 78-1146

1930951

2ND FLOOR
BUILDING "B"
SHORELY WOOD CONDOMINIUM APARTMENTS
BARRINGTON, ILLINOIS

Scale: 1 inch = 10 feet Date: June 1st, 1978

SCANNED FROM COPY
PROVIDED BY [illegible] AT
TIME OF RECORDING
#1930951
7-14-78

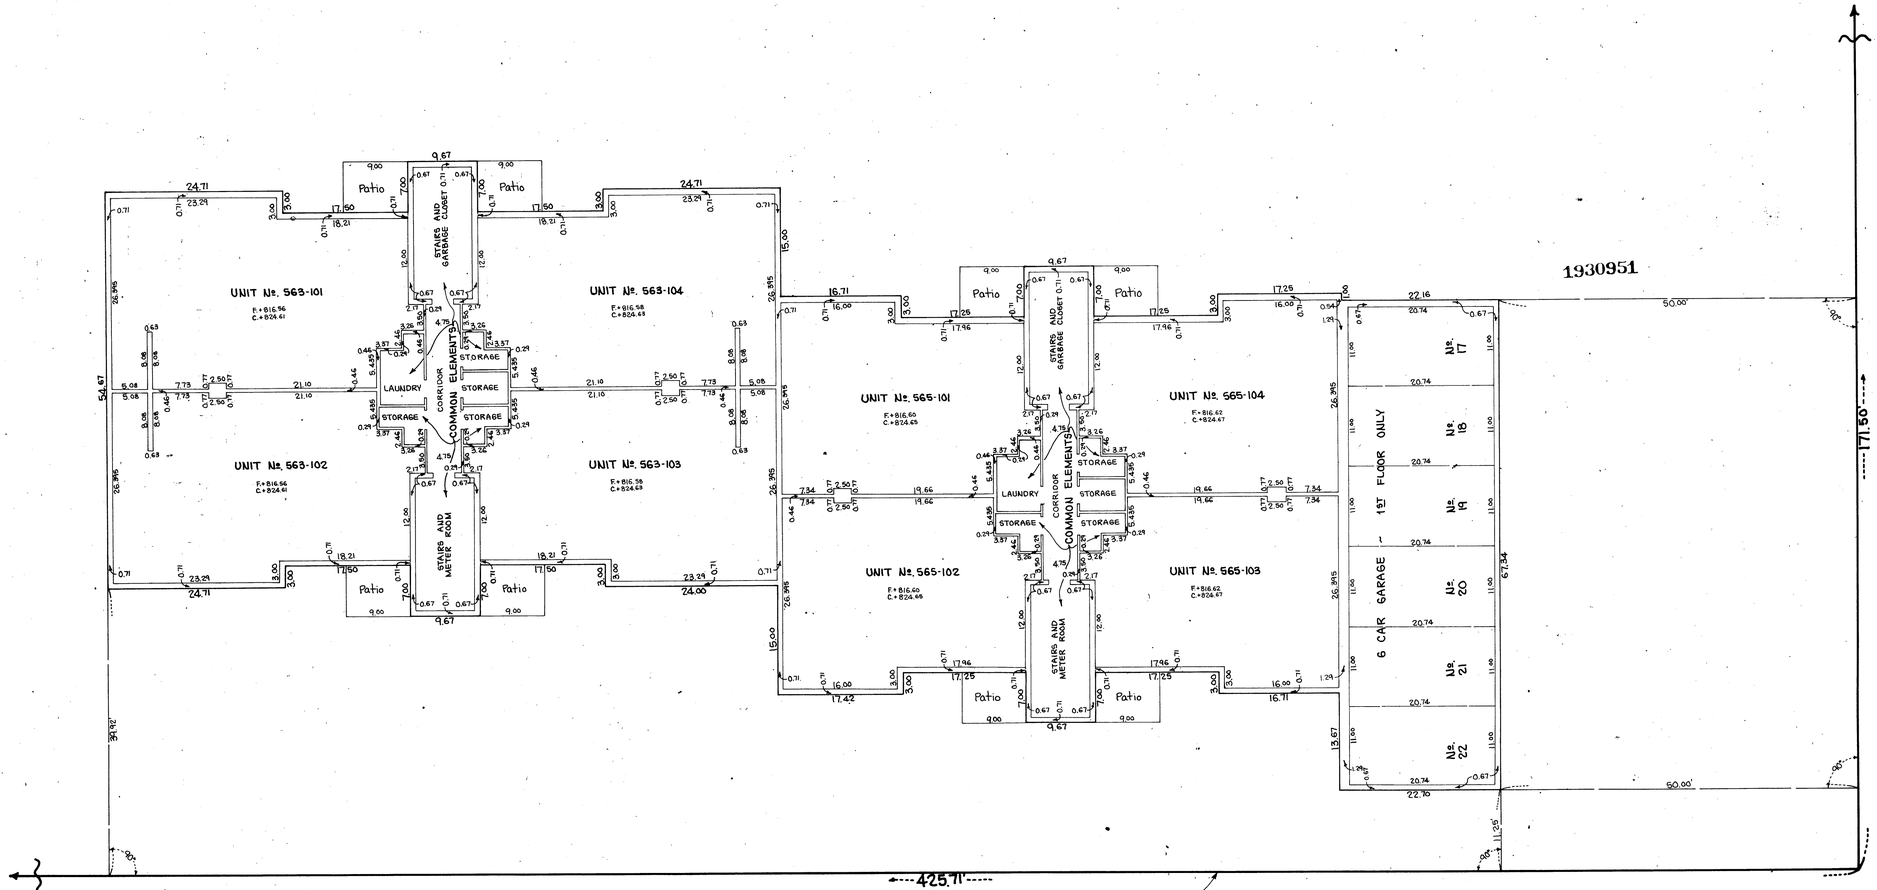

1930951

Note!

All elevations shown hereon (C= Ceiling elevation ~ F= Floor elevation) refer to: BENCH MARK: Top of Southwest flange bolt of Fire Hydrant located 9 feet South and 71 feet East of the Northeast corner of Building "B", ELEVATION = + 815.88.

All dimensions and elevations are shown in feet and decimal parts thereof.

Note!

Horizontal boundaries of units are formed by the interior surface of the concrete floors and the interior finished surface of the ceilings.

Vertical boundaries of units are formed by the interior finished surface of the perimeter walls and the lateral extensions thereof.

1930951

Prepared by:
REBIK & ASSOCIATES, INC.
Land and Construction Surveys
825 Village Quarter Road, Suite B-1
Dundee, Illinois 60118
Phone: (312) 428-3456

ORDER No. 78-1146

1ST FLOOR
BUILDING "C"
SHORELY WOOD CONDOMINIUM APARTMENTS
BARRINGTON, ILLINOIS

Scale: 1 inch = 10 feet Date: June 1st, 1978

SCANNED FROM CC
PROVIDED F
TIML
#193095/
7-14-78

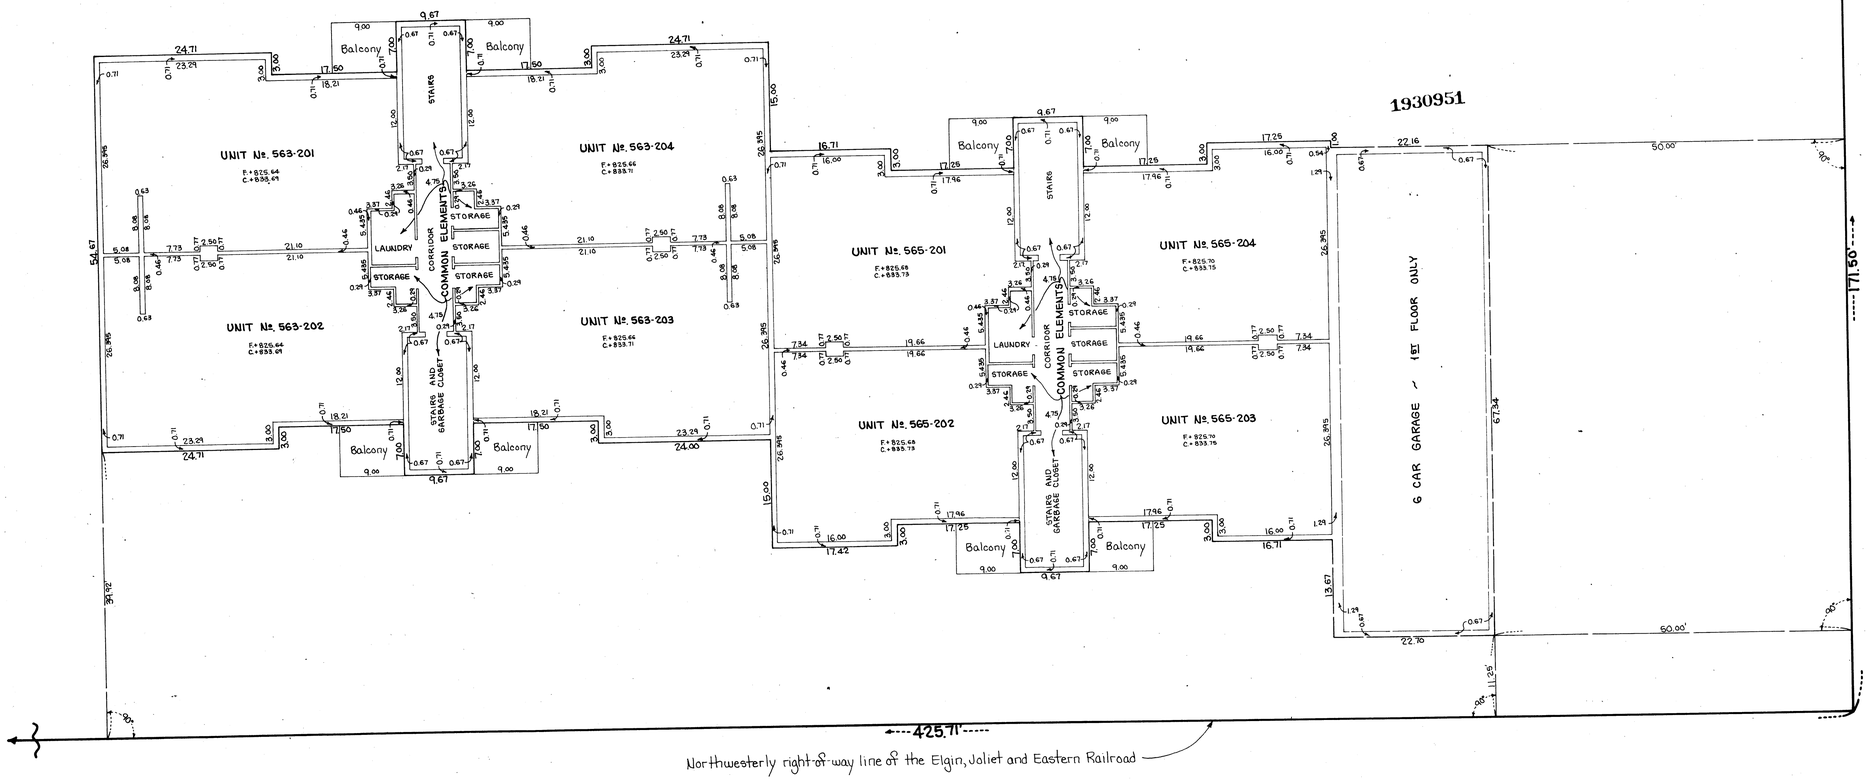

1930951

Note!

All elevations shown hereon (C = Ceiling elevation – F = Floor elevation) refer to: **BENCH MARK**: Top of Southwest flange bolt of Fire Hydrant located 9 feet South and 71 feet East of the Northeast corner of Building "B", ELEVATION = +815.88.

All dimensions and elevations are shown in feet and decimal parts thereof.

Note!

Horizontal boundaries of units are formed by the interior surface of the concrete floors and the interior finished surface of the ceilings.

Vertical boundaries of units are formed by the interior finished surface of the perimeter walls and the lateral extensions thereof.

1930951

Prepared by:
REBIK & ASSOCIATES, INC.
Land and Construction Surveys
825 Village Quarter Road, Suite B-1
Dundee, Illinois 60118
Phone: (312) 428-3456

ORDER NO. 78-1146

2ND FLOOR
BUILDING "C"
SHORELY WOOD CONDOMINIUM APARTMENTS
BARRINGTON, ILLINOIS

Scale: 1 inch = 10 feet Date: June 1st, 1978

SCANNED FROM COPY
PROVIDED BY CUSTOMER AT
TIME OF RECORDING

#1930951
7-14-78

NORTH

1930951

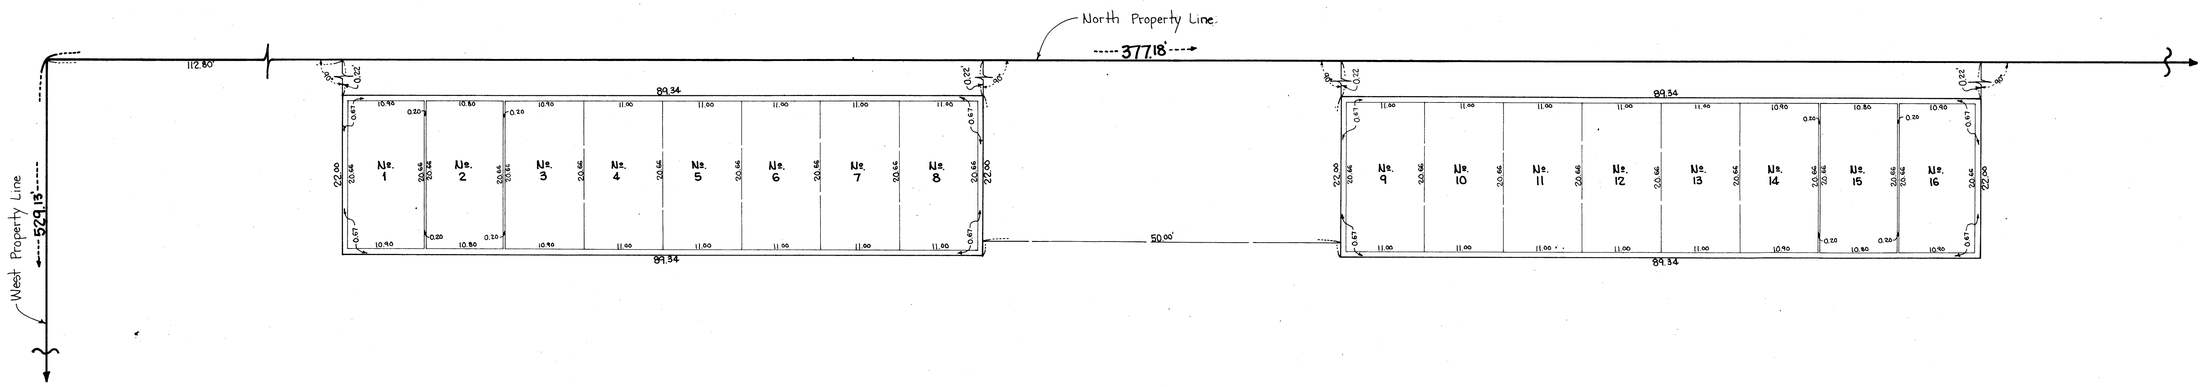

1930951

1930951

Prepared by:
REBIK & ASSOCIATES, INC.
Land and Construction Surveys
825 Village Quarter Road, Suite B-1
Dundee, Illinois 60118
Phone: (312) 428-3456
ORDER No. 78-1146

2 8-CAR
GARAGES
SHORELY WOOD CONDOMINIUM APARTMENTS
BARRINGTON, ILLINOIS

Scale: 1 inch = 10 feet Date: June 1st, 1978

SCANNED FROM COPY
PROVIDED BY CUSTOMER AT
TIME OF RECORDING

#1930951
7-14-78

NORTH

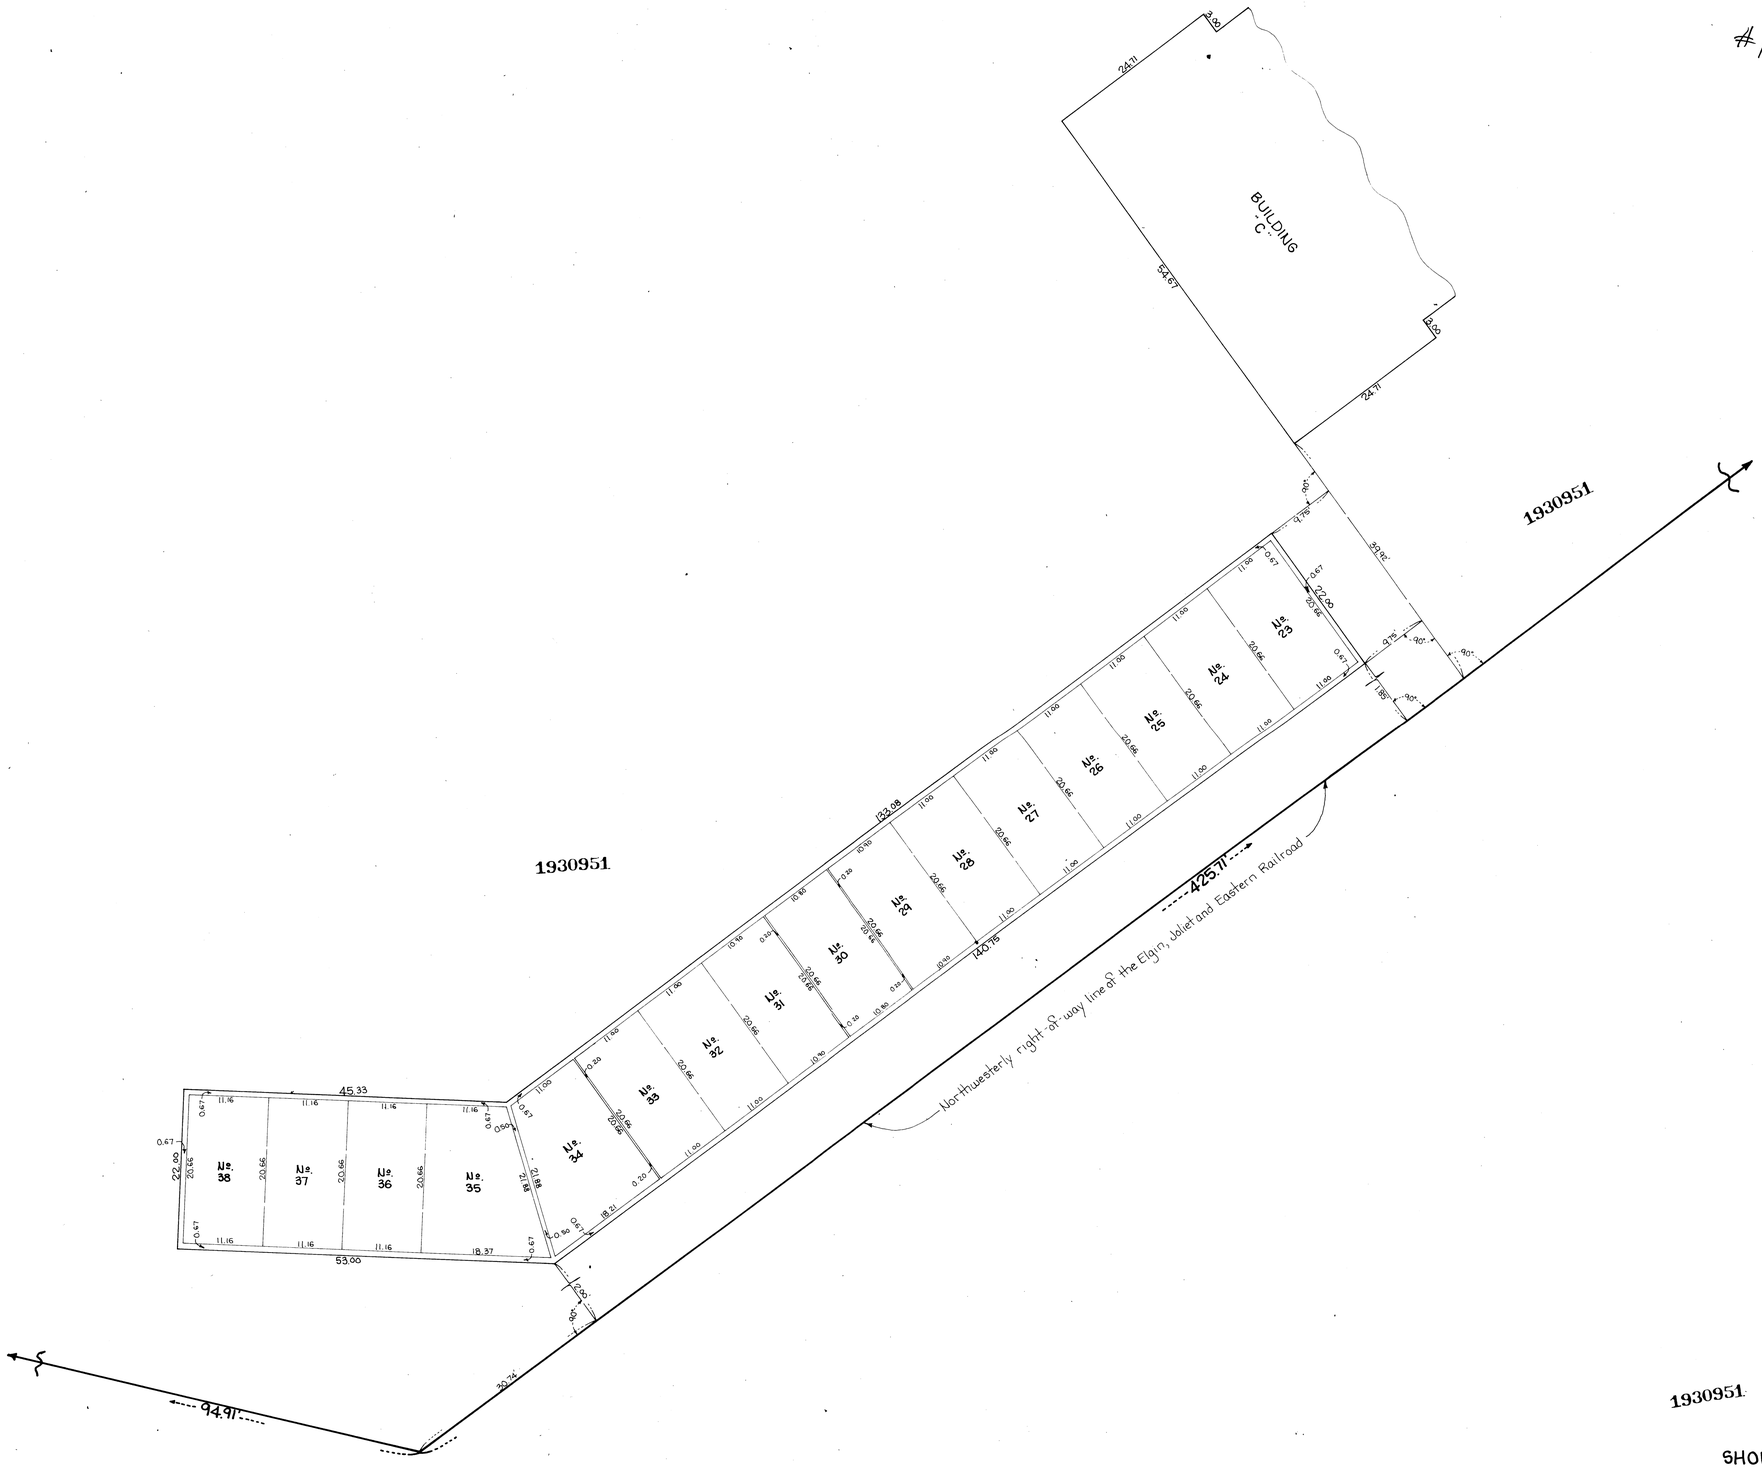

Prepared by:
REBIK & ASSOCIATES, INC.
Land and Construction Surveys
825 Village Quarter Road, Suite B-1
Dundee, Illinois 60118
Phone: (312) 428-3456
ORDER NO. 78-1146

1930951

16-CAR GARAGE
SHORELY WOOD CONDOMINIUM APARTMENTS
BARRINGTON, ILLINOIS

Scale: 1 inch = 10 feet Date: June 1st, 1978

Sheet 9 of 9